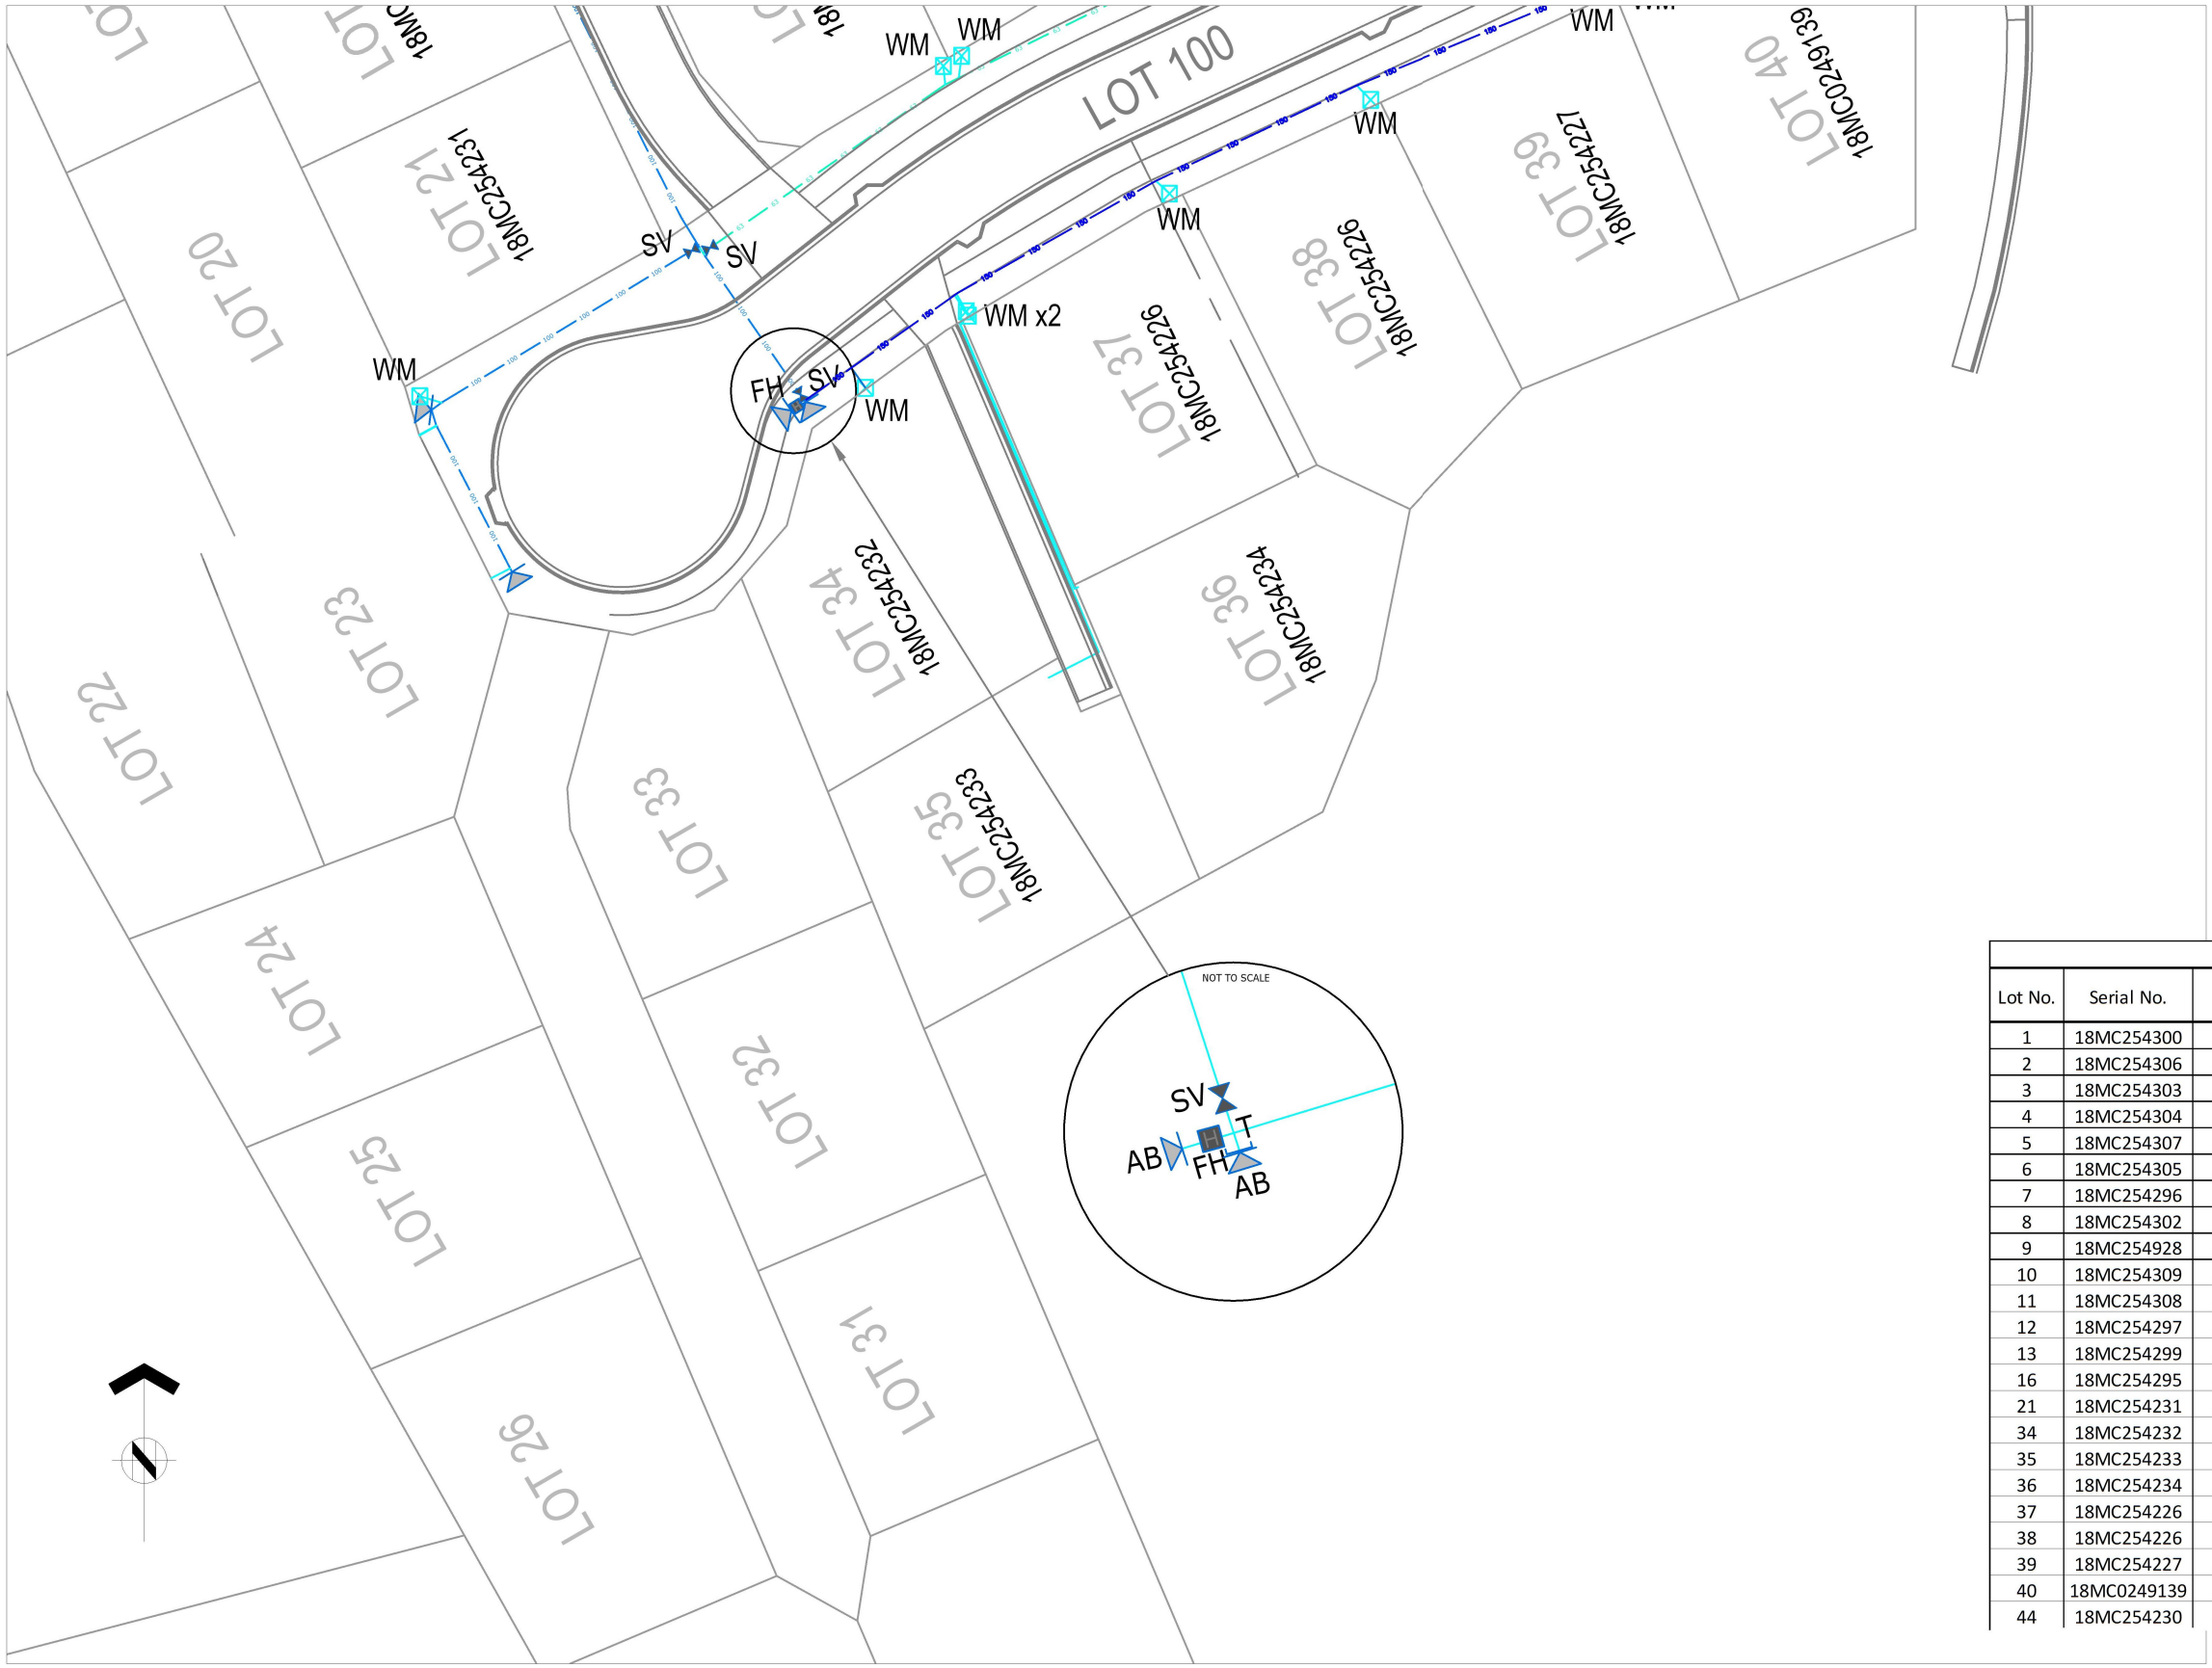

WATERMAIN ASBUILT NOTES

NOTES:

1. ALL COORDINATES ARE IN METRES AND IN TERMS OF NZGD2000 BAY OF PLENTY, MOTURIKI VERTICAL DATUM 1953
2. THESE DRAWINGS DO NOT NECESSARY SHOW ALL EXISTING SERVICES.
3. ALL WORKS AND MATERIALS COMPLY WITH TAURANGA CITY COUNCIL SERVICES STANDARDS.
5. ALL TRENCHS UNDER CARRIAGEWAY ARE BACKFILLED WITH HARDFILL.
6. INSTALLATION DATE: JUN-DEC 2018

LEGEND

- 150 — AS-BUILT DN150 WATERMAIN (uPVC BLUE PN12)
- 100 — AS-BUILT DN100 WATERMAIN (uPVC BLUE PN12)
- 63 — AS-BUILT 63mm MDPE WATERMAIN (PE80B PN12.5 SDR11 BLUE)
- AS-BUILT 25mm MDPE WATERMAIN (PE80B PN12.5 SDR11 BLUE)
- AS-BUILT SLUICE VALVE
- AS-BUILT FIRE HYDRANT
- AS-BUILT PEET VALVE
- AS-BUILT ANCHOR BLOCK
- AS-BUILT BLIND CAP
- AS-BUILT METER BOX

Watermeter Schedule

Lot No.	Serial No.	mN	mE	RL (m)	Front (m)	Side (m)	Initial Reading
1	18MC254300	803602.532	376721.550	36.88	0.3	0.5	104
2	18MC254306	803601.017	376717.429	36.79	0.4	4	105
3	18MC254303	803600.887	376716.996	36.75	0.4	4.4	103
4	18MC254304	803600.747	376716.663	36.71	0.4	4.7	104
5	18MC254307	803595.025	376703.294	35.66	0.4	0.7	104
6	18MC254305	803587.932	376688.321	34.70	0.5	0.4	104
7	18MC254296	803580.790	376674.133	33.66	0.3	0.9	105
8	18MC254302	803580.107	376672.876	33.30	0.3	0.6	104
9	18MC254928	803593.755	376649.341	30.78	0.1	1.0	103
10	18MC254309	803617.582	376636.623	29.35	0.2	1.3	104
11	18MC254308	803617.843	376637.256	29.40	0.2	0.7	104
12	18MC254297	803617.715	376636.934	29.38	0.2	1	104
13	18MC254299	803617.466	376636.307	29.33	0.2	1.7	104
16	18MC254295	803597.473	376640.403	30.23	0.4	1.1	182
21	18MC254231	803557.414	376636.934	29.95	1.1	0.8	181
34	18MC254232	803557.997	376667.528	32.99	0.1	4.7	181
35	18MC254233	803562.957	376674.607	33.04	0.1	3.8	182
36	18MC254234	803563.244	376674.454	33.06	0.4	4.0	181
37	18MC254226	803571.333	376688.404	34.22	0.4	0.8	184
38	18MC254226	803577.774	376702.222	35.27	0.4	0.5	182
39	18MC254227	803585.112	376718.173	36.41	0.4	0.8	182
40	18MC0249139	803585.601	376719.269	36.51	0.4	0.4	105
44	18MC254230	803596.205	376641.009	30.48	0.4	0.3	182

PEMBERTON

91 RUFFELL ROAD
P.O Box 10114
Ph: 07 850 1042
Fax: 07 850 1045

2 Waikite Road, Tauranga
Watermain Asbuilt Plan

Surveyor: SY	Sheet: 3	PC Job Number:	T2017003
Drawn: EN	Version: 2	Issue Status:	ASBUILT
Checked: JW	Reference:		IP25343
Approved: JS	Drawing Title:		WATERMAIN

PREPARED FOR: Classic Developments DATE: 18-12-2018 SCALE: 1:500 at A3

COPYRIGHT: The copyright for the information shown on this plan remains the right of Pemberton Civil Ltd. It may not be reproduced (wholly or in part), without consent from Pemberton Civil Ltd.